LAND OF BOSTON AND MAINE CORP(

TAX MAP 999 LOT 11

CL LOCA

N13°37'00"E
339.60'

50
50.00
1setHUB

12'

ROOF

108
107
CORDRIP
CORDK

52.06
corbld*

52.09
corbld*

46.00'

S13°37'00"W

52.04
@post

EXISTING BUILDING

52.07
corbld*

13.4'

110
CORDRIP

DECK

L3

L2

109
51.60
CORDK

52.48
corbld*

L1

105
TREE

106
TREE

102
@post
COREP

100
EP

APPROX EP

101
@NDIPIN

75
52.43
lmppst

104
EP

APPROX EP

81
51.51
lmppst

97
COREP

76
53.33
pole

98
CBASIN

103
COREP

| No. | Bearing |
|---|---|
| L1 | S76°23'0 |
| L2 | S13°37'0 |
| L3 | S76°23'0 |
| L4 | S76°23'0 |

111
@CORHVAC
112
PROPANE

APPROX EXIS
UTILITIES

EXISTING
PROPERTY LINE

EXISTING
ASPHALT PAD

CL LOCATION

32
52.55
setspk

33
52.46
setspk

6'±

37
52.68
edgpad

28
52.73
inst

38
52.01
pad
52.06
pad

39
52.67
pad

40
52.96
pad

30
52.83
setspk

31
50.98
pad
52.83
setspk

CL LOCATION STA 2571+80.52
(REF RCRD PLAN 1574-297)

11.5'

3'±

29
RRSPK

RRSPKWSH

43.00'
N76°23'00"W

SET RR SPK
& WASHER

204

SETIPBAS

SET IP

513
51.42
1setHUB

7.8'

78
FND RR SPK
IN U-POLE
51.45
spkpol**

53
50.50
3setpk

80
49.19
rebar***

0.4'±

90
50.53
REBAR**

FND 3' HIGH REBAR
W/ WHITE PAINT

TAX MAP 7 LOT 77
PHILIP AND SHERRI THAYER
206B ATLANTIC AVE
NO HAMPTON, NH 03862

TAX MAP 7 LOT 76

435.85'
S13°37'00"W

N13°37'00"E
195.58'

see job 757

7/11/11 BAKER PAD

(28) ON ~~PAD~~

HI 57.73

| | | | | |
|---|---|---|---|---|
| | 00-00 | 26.98 | -1.47 | 4.84 |
| | 88-41-40 | 45.68 | -0.73 | " |
| 30 | 88-26-25 | 31.11 | -0.22 | " |
| 31 | 58-30-50 | 25.99 | -0.06 | " |
| 32 | 177-36-25 | 15.75 | -0.34 | " |
| 33 | 260-17-25 | 6.33 | -0.43 | " |
| 34 | 234-41-15 | 71.73 | -1.29 | " |
| 35 | 247-07-25 | 71.67 | -0.74 | " |
| 36 | 237-52-25 | 142.78 | -0.83 | " |
| 37 | 129-29-00 | 16.06 | -0.21 | " |
| 38 | 90-02-35 | 15.14 | +0.12 | " |
| 39 | 55-07-55 | 13.51 | -0.05 | " |
| 40 | 159-53-55 | 13.41 | -0.22 | " |
| 41 | 86-15-40 | 27.60 | +0.07 | " |
| 42 | 60-17-15 | 24.24 | +0.09 | " |
| 43 | 86-00-15 | 16.70 | +0.17 | " |

CHK 00 — OK

~~RWB~~ RVB & RVB

MY HUB 54

(29) 22=115

RR SPK LOT COR

Set SPK

" "

" " (FLUSH)

Set SPK

~~I GND @ C~~ COR DECK GND EL

COR ~~DECK~~ BLDG (DECK EL)

~~COR DECK~~

COR DECK

EDGE PAD

PAD

EDG PAD

PAD

PAD

"

PAD



Rite in the Rain

Stockton Services
PO Box 1306
Hampton, NH 03843-1306
603 929-7404

Scott Baker
208 Atlantic Avenue
North Hampton, NH

Statement 07/22/19

Locus: 208 Atlantic Ave, North Hampton

Research, consultation, site check,
ZBA sketches for proposed shed . . . . . .$ 200.00

**Balance due . . . . . $ 200.00**

Thank you.

*Tocky*

Stockton Services
PO Box 1306
Hampton, NH 03843-1306
603 929-7404

Scott Baker
208 Atlantic Avenue
North Hampton, NH

Statement 09/03/19

Locus: 208 Atlantic Ave, North Hampton

Previous invoice (07/22/19). . . . . .$ 200.00
Payment received, Thank you! . . . . . $ 200.00
Balance . . . . . $ 00.00

Field location of existing asphalt pad,
Survey calcs, working drawing provided . . . . . .$ 175.00

**Balance due . . . . . $ 175.00**

Thank you.

*Tocky*

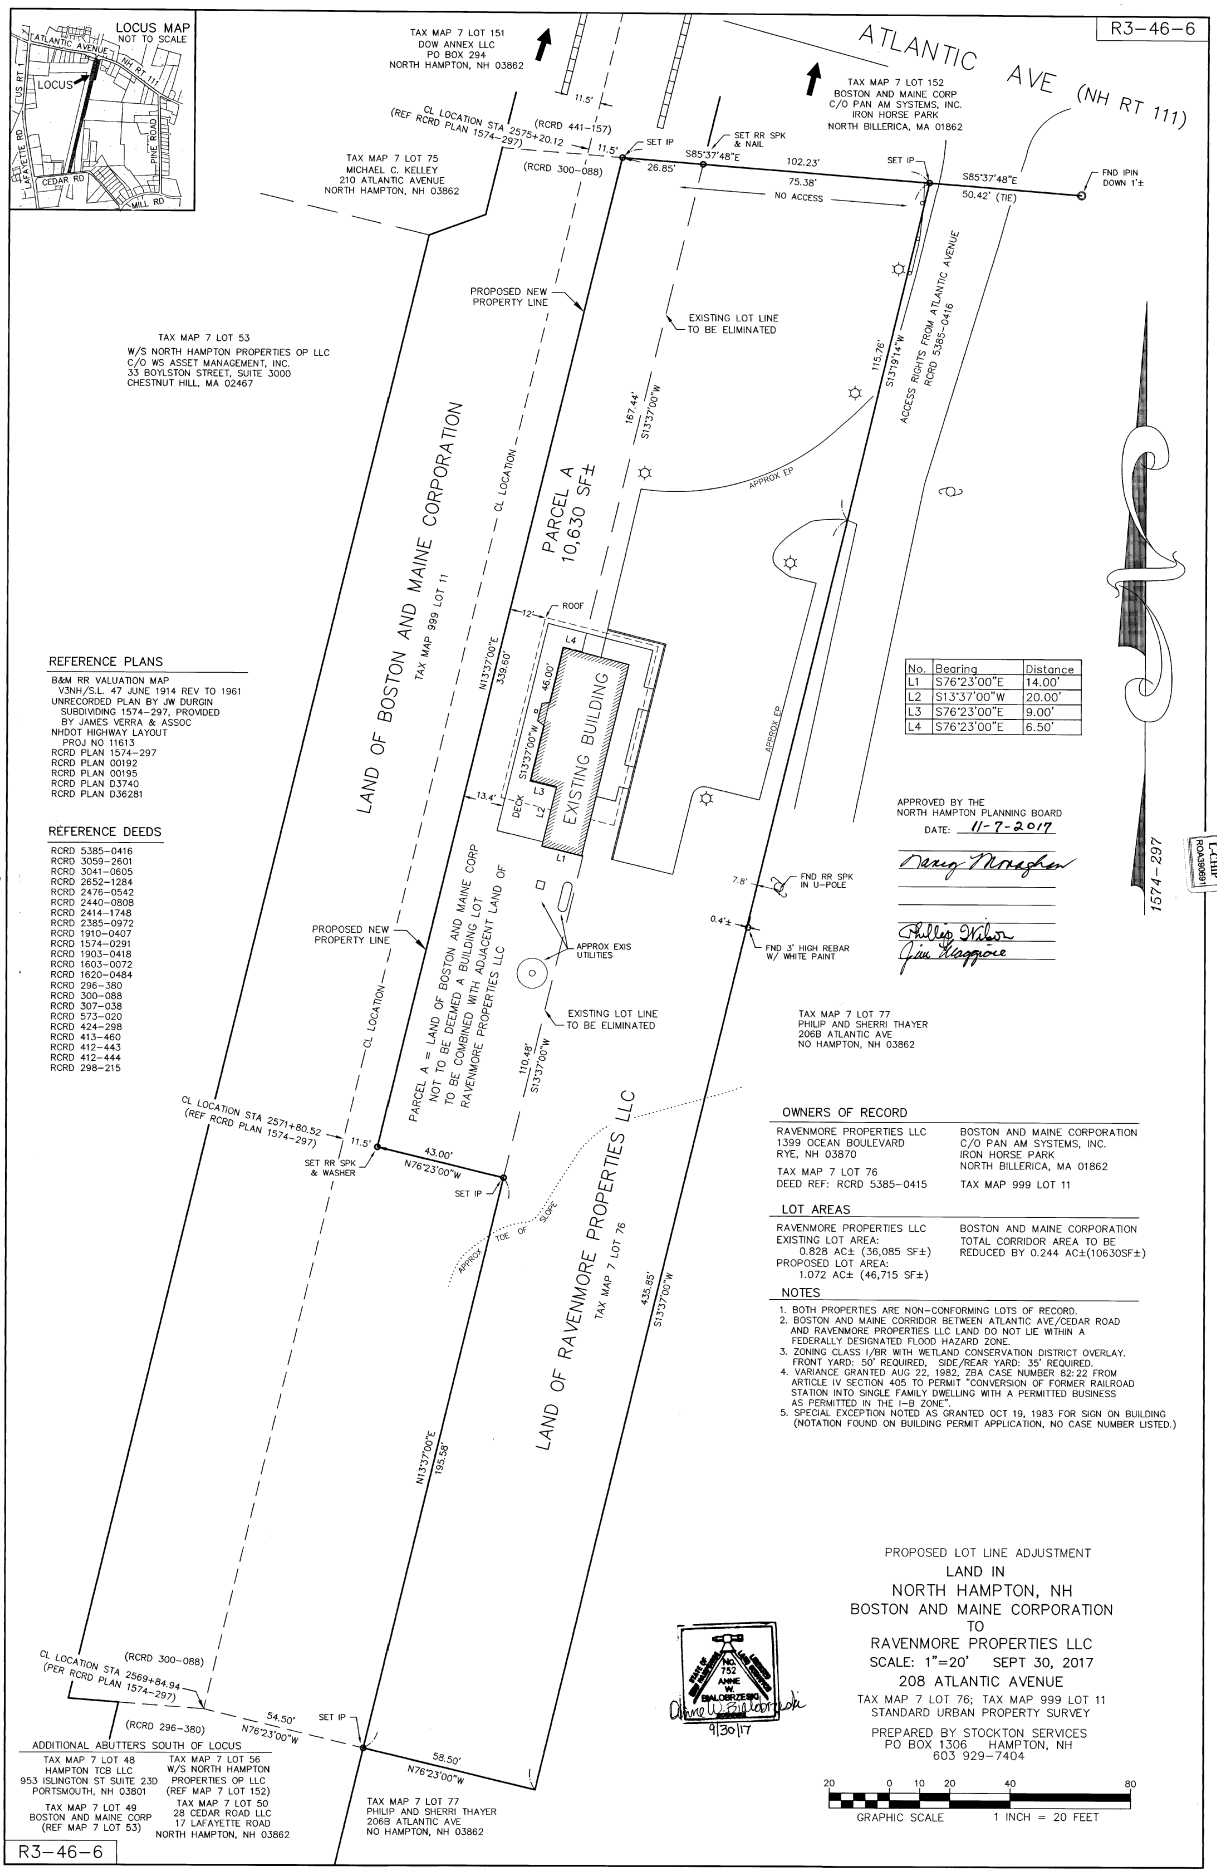


D-40507

2017 NOV 16 AM 8:10

051027

757

Printed from Internet for on 11/24/2017

I SET SPIKES AT BEST ESTIMATE OF
PAD CORNERS AS THEY APPEARED
ON THE GROUND. YOU'LL SEE SOME ARE
LOWER THAN PAVEMENT ELEVATION, BUT
PAD IS OUT OF LEVEL BY UP TO 4".

PRINT THIS ACTUAL SIZE (NOT FIT
TO PAGE) FOR 1"=20'

POINT #28 IS INSTRUMENT
HEIGHT NOT PAD ELEVATION

LET ME KNOW WHAT ELSE
YOU WANT ME TO DO WITH THIS.

TOCKY 9/2/19

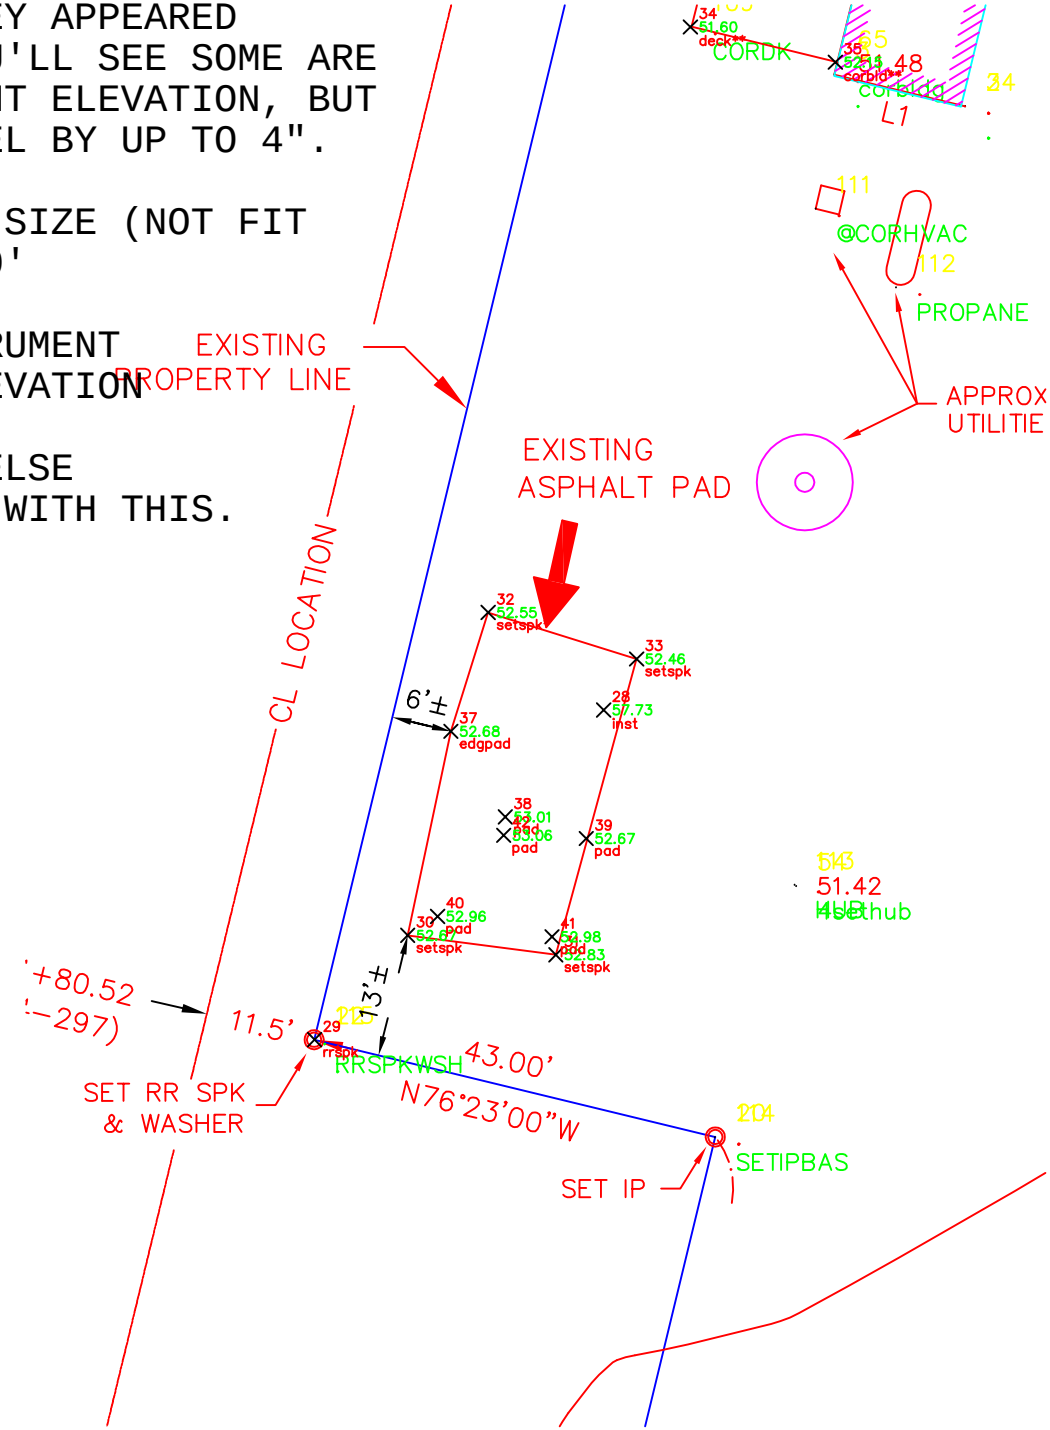

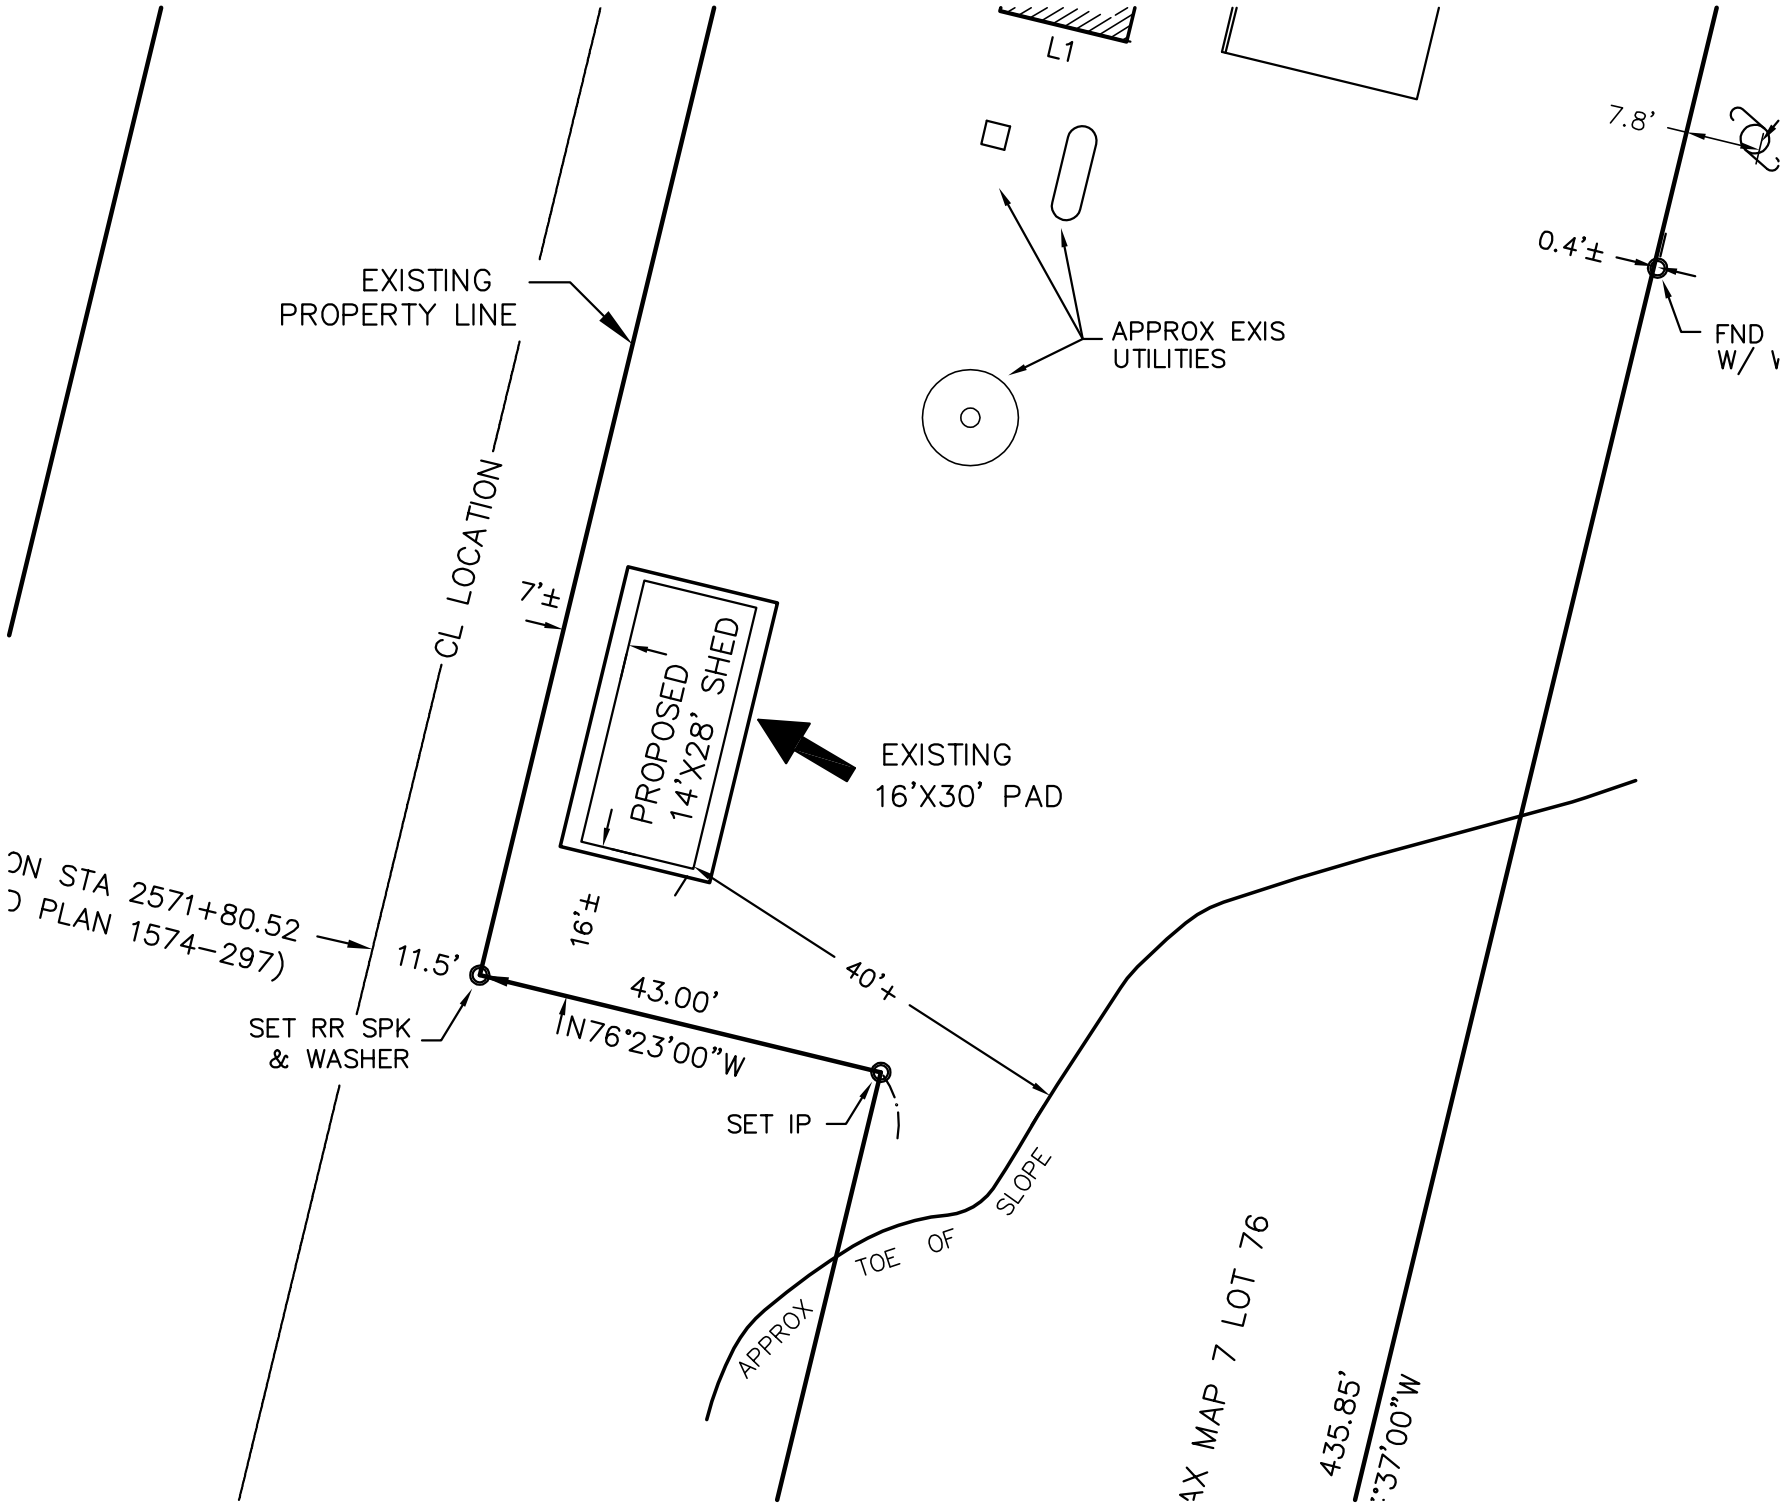
L1
7.8'
0.4'±
FND
W/
EXISTING
PROPERTY LINE
APPROX EXIS
UTILITIES
CL LOCATION
7'±
PROPOSED
14'X28' SHED
EXISTING
16'X30' PAD
16'±
40'±
ON STA 2571+80.52
O PLAN 1574-297)
11.5'
43.00'
N76°23'00"W
SET RR SPK
& WASHER
SET IP
APPROX TOE OF SLOPE
AX MAP 7 LOT 76
435.85'
:37'00"W

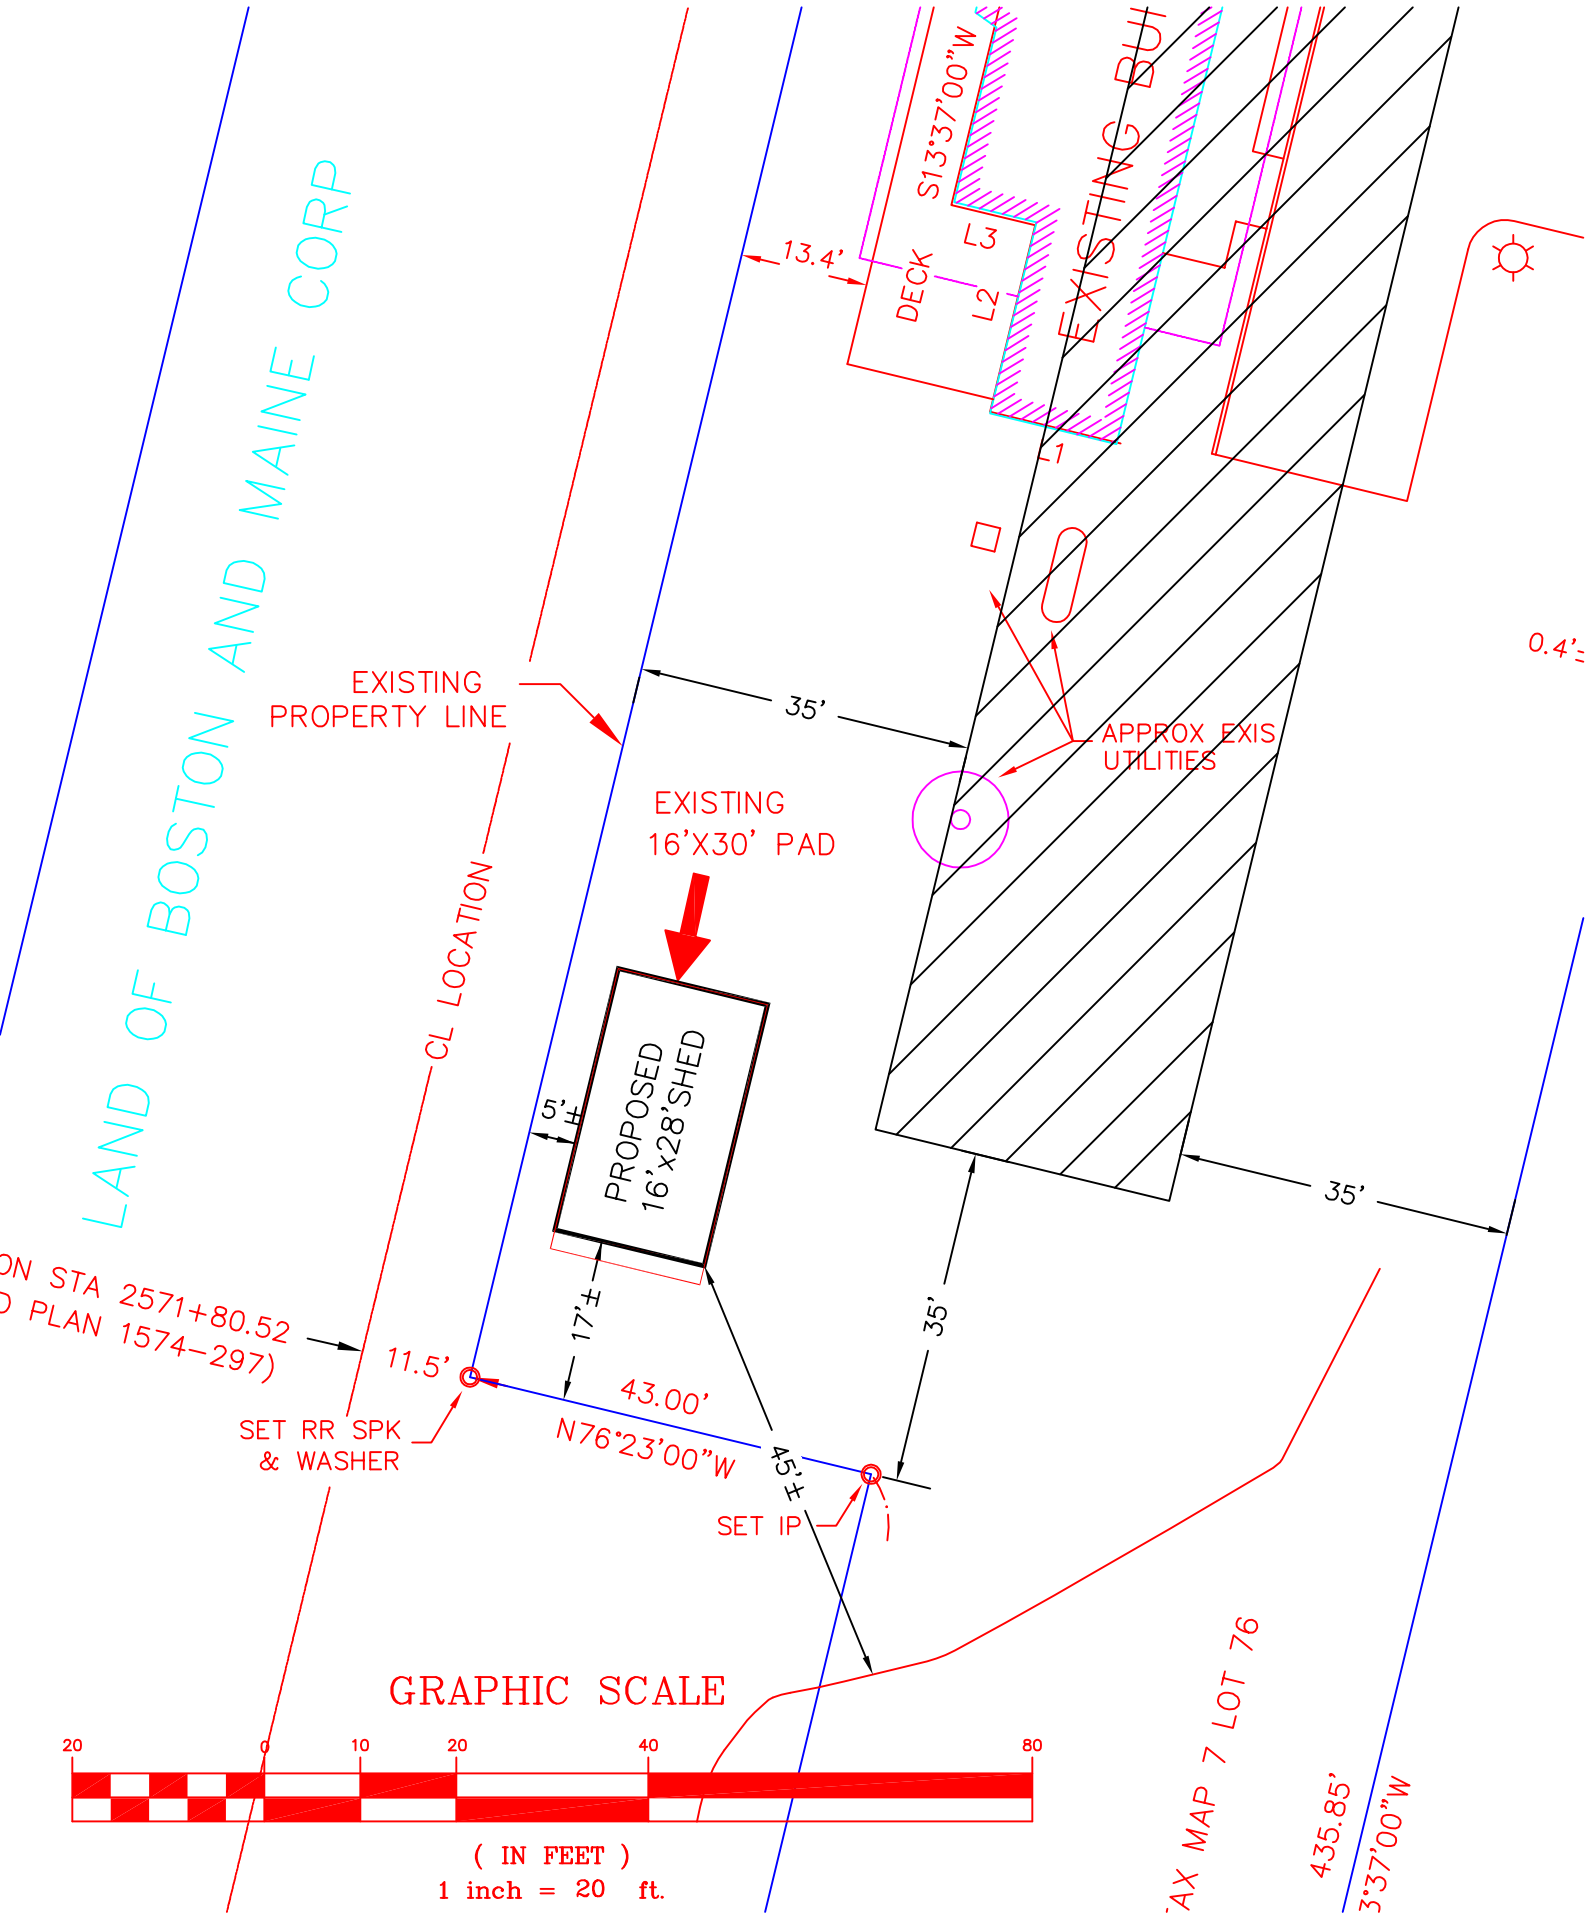
LAND OF BOSTON AND MAINE CORP
EXISTING PROPERTY LINE
CL LOCATION
EXISTING 16'X30' PAD
PROPOSED 16'x28' SHED
5'±
17'±
35'
35'
35'
13.4'
DECK
L2
L3
L1
EXISTING BUI
S13°37'00"W
APPROX EXIS UTILITIES
0.4'
ON STA 2571+80.52
D PLAN 1574-297)
11.5'
SET RR SPK & WASHER
43.00'
N76°23'00"W
45'±
SET IP
GRAPHIC SCALE
20 0 10 20 40 80
( IN FEET )
1 inch = 20 ft.
AX MAP 7 LOT 76
435.85'
3°37'00"W

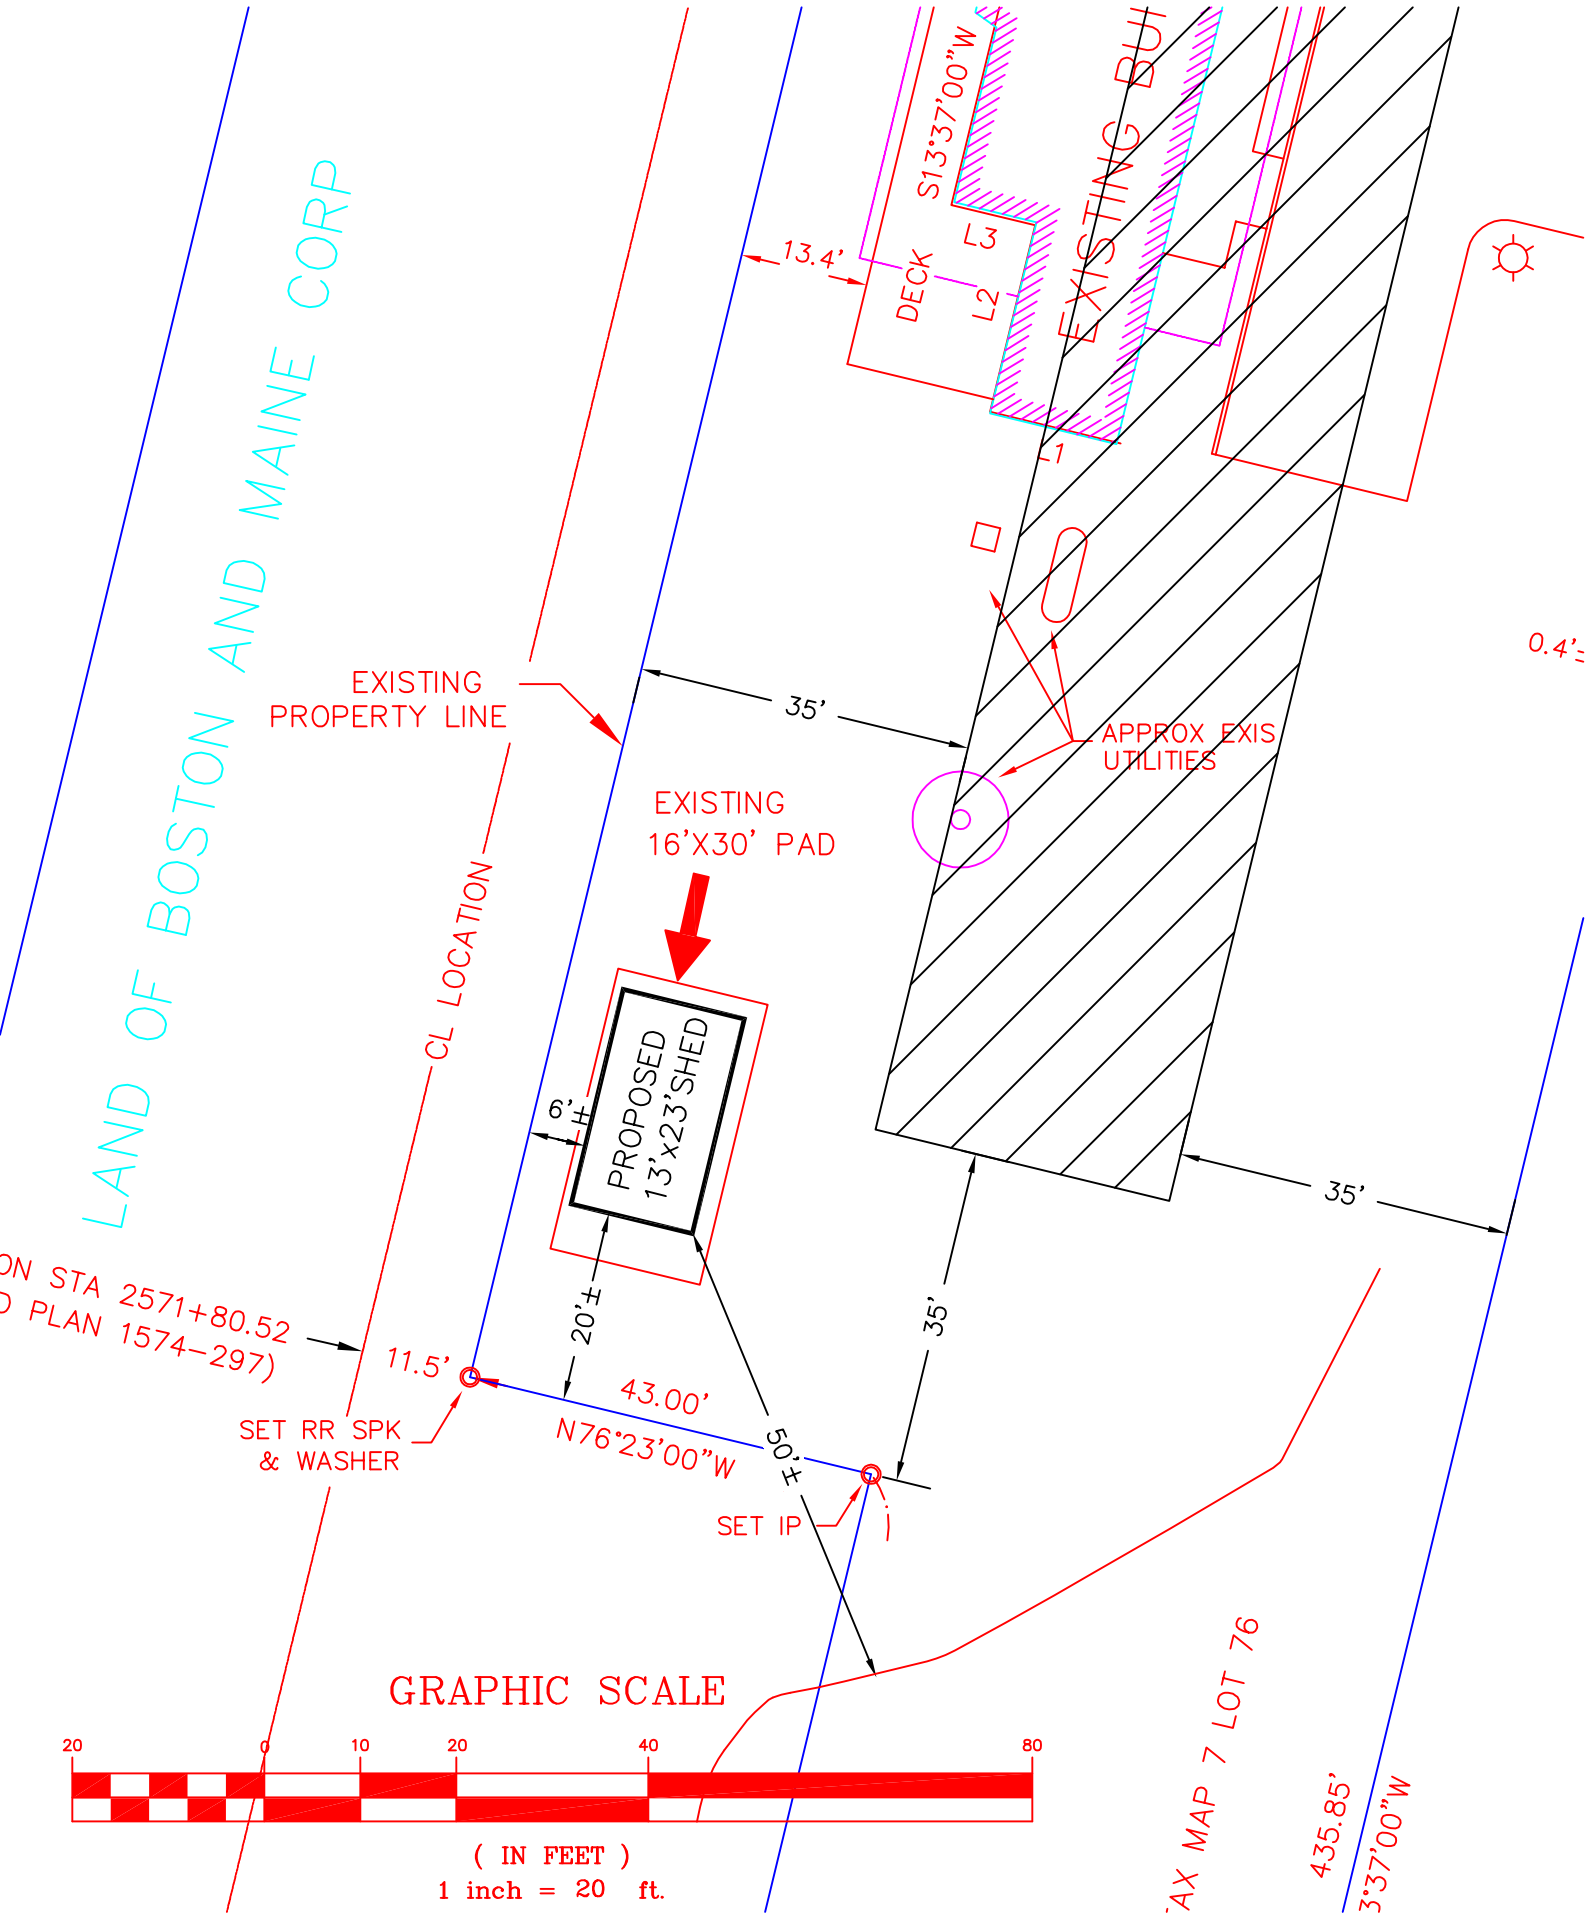
LAND OF BOSTON AND MAINE CORP
EXISTING PROPERTY LINE
CL LOCATION
EXISTING 16'X30' PAD
PROPOSED 13'x23'SHED
6'±
20'±
35'
35'
35'
13.4'
DECK
L2
L3
L1
EXISTING BUI
S13°37'00"W
APPROX EXIS UTILITIES
0.4'
ON STA 2571+80.52
D PLAN 1574-297)
11.5'
SET RR SPK & WASHER
43.00'
N76°23'00"W
50'±
SET IP
GRAPHIC SCALE
20 0 10 20 40 80
( IN FEET )
1 inch = 20 ft.
AX MAP 7 LOT 76
435.85'
3°37'00"W

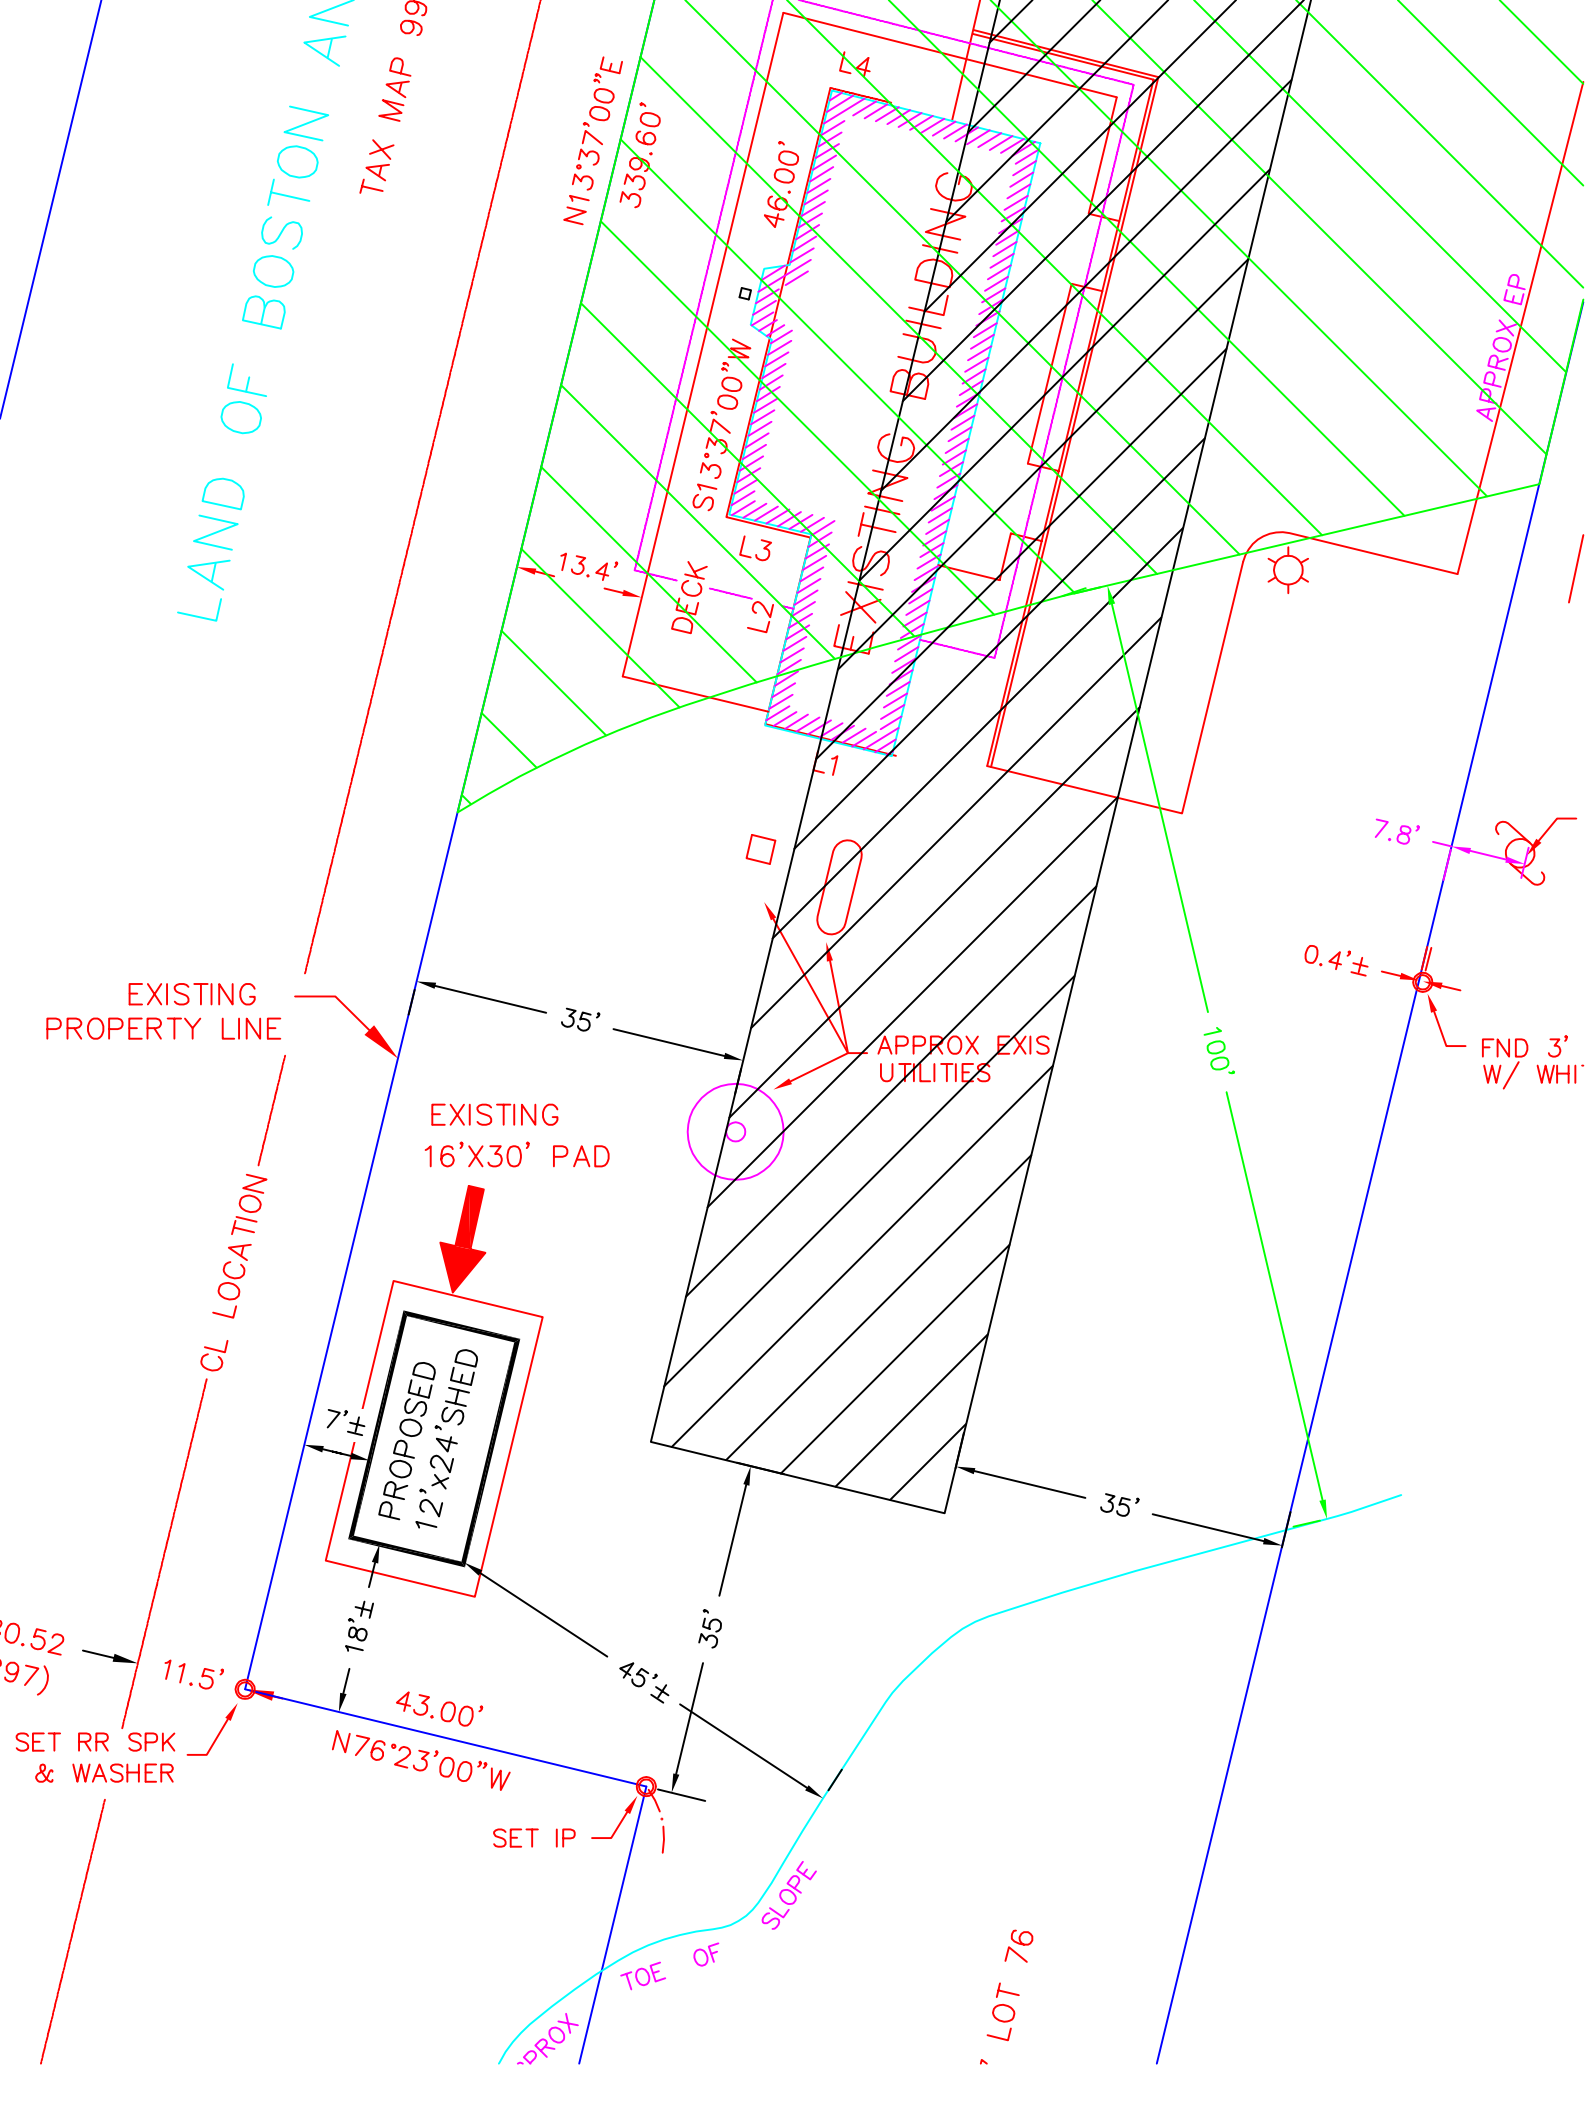
LAND OF BOSTON AN
TAX MAP 99
N13°37'00"E
339.60'
46.00'
S13°37'00"W
L4
L3
L2
L1
EXISTING BUILDING
APPROX EP
13.4'
DECK
7.8'
0.4'±
FND 3'
W/ WHI
EXISTING
PROPERTY LINE
35'
APPROX EXIS
UTILITIES
100'
EXISTING
16'X30' PAD
CL LOCATION
PROPOSED
12'x24'SHED
7'±
18'±
35'
35'
45'±
11.5'
43.00'
N76°23'00"W
SET RR SPK
& WASHER
SET IP
TOE OF SLOPE
LOT 76